


SEPTIC FORM

Private Sewage Facility (Licensed) in Kendall County, Texas

APPLICANT INFORMATION:

Property Owner (Licensee) Steve Remmett Contractor Bobby Hoang
 Subdivision or Location 242 Prado Crossing
 Total Area Sq. Ft. _____ or Acres 3.37
 No. Bedrooms 4 or Sq. Ft. of House 2490 + 500 of Gal/Day 420
 Perc Rate .2 Class No. III Trench Req. Sq. Ft. 2100
 or Bed Req. Sq. _____
 Gallon Capacity Req. for Concrete Septic Tank 1250 2 Compartment
 Installed: Length 429 Width 3
 Sq. Ft. 2145 Bed _____ Trench ✓

Remarks: _____
 (Sketch of Approximate Distances, Not To Scale.)

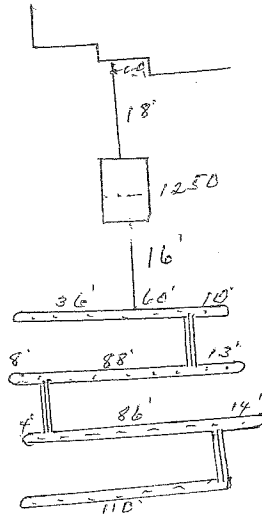

The County of Kendall, The Texas Department of Health, or their agents or designees, makes no representation that facilities herein licensed will provide satisfactory service to the premises served. It will be the licensee's responsibility to make any changes or modifications which operating experience may show to be necessary in order for these facilities to provide satisfactory service. Septic distances meet minimum Texas Department of Health separation distances in most instances. Some renovations may be less if repaired or replaced in the same general area as the pre-existing system being renovated.

PERMIT (LICENSE) GRANTED AND APPROVED THIS DATE 2-10-04

Stanford J. ...
 Designated Representative